



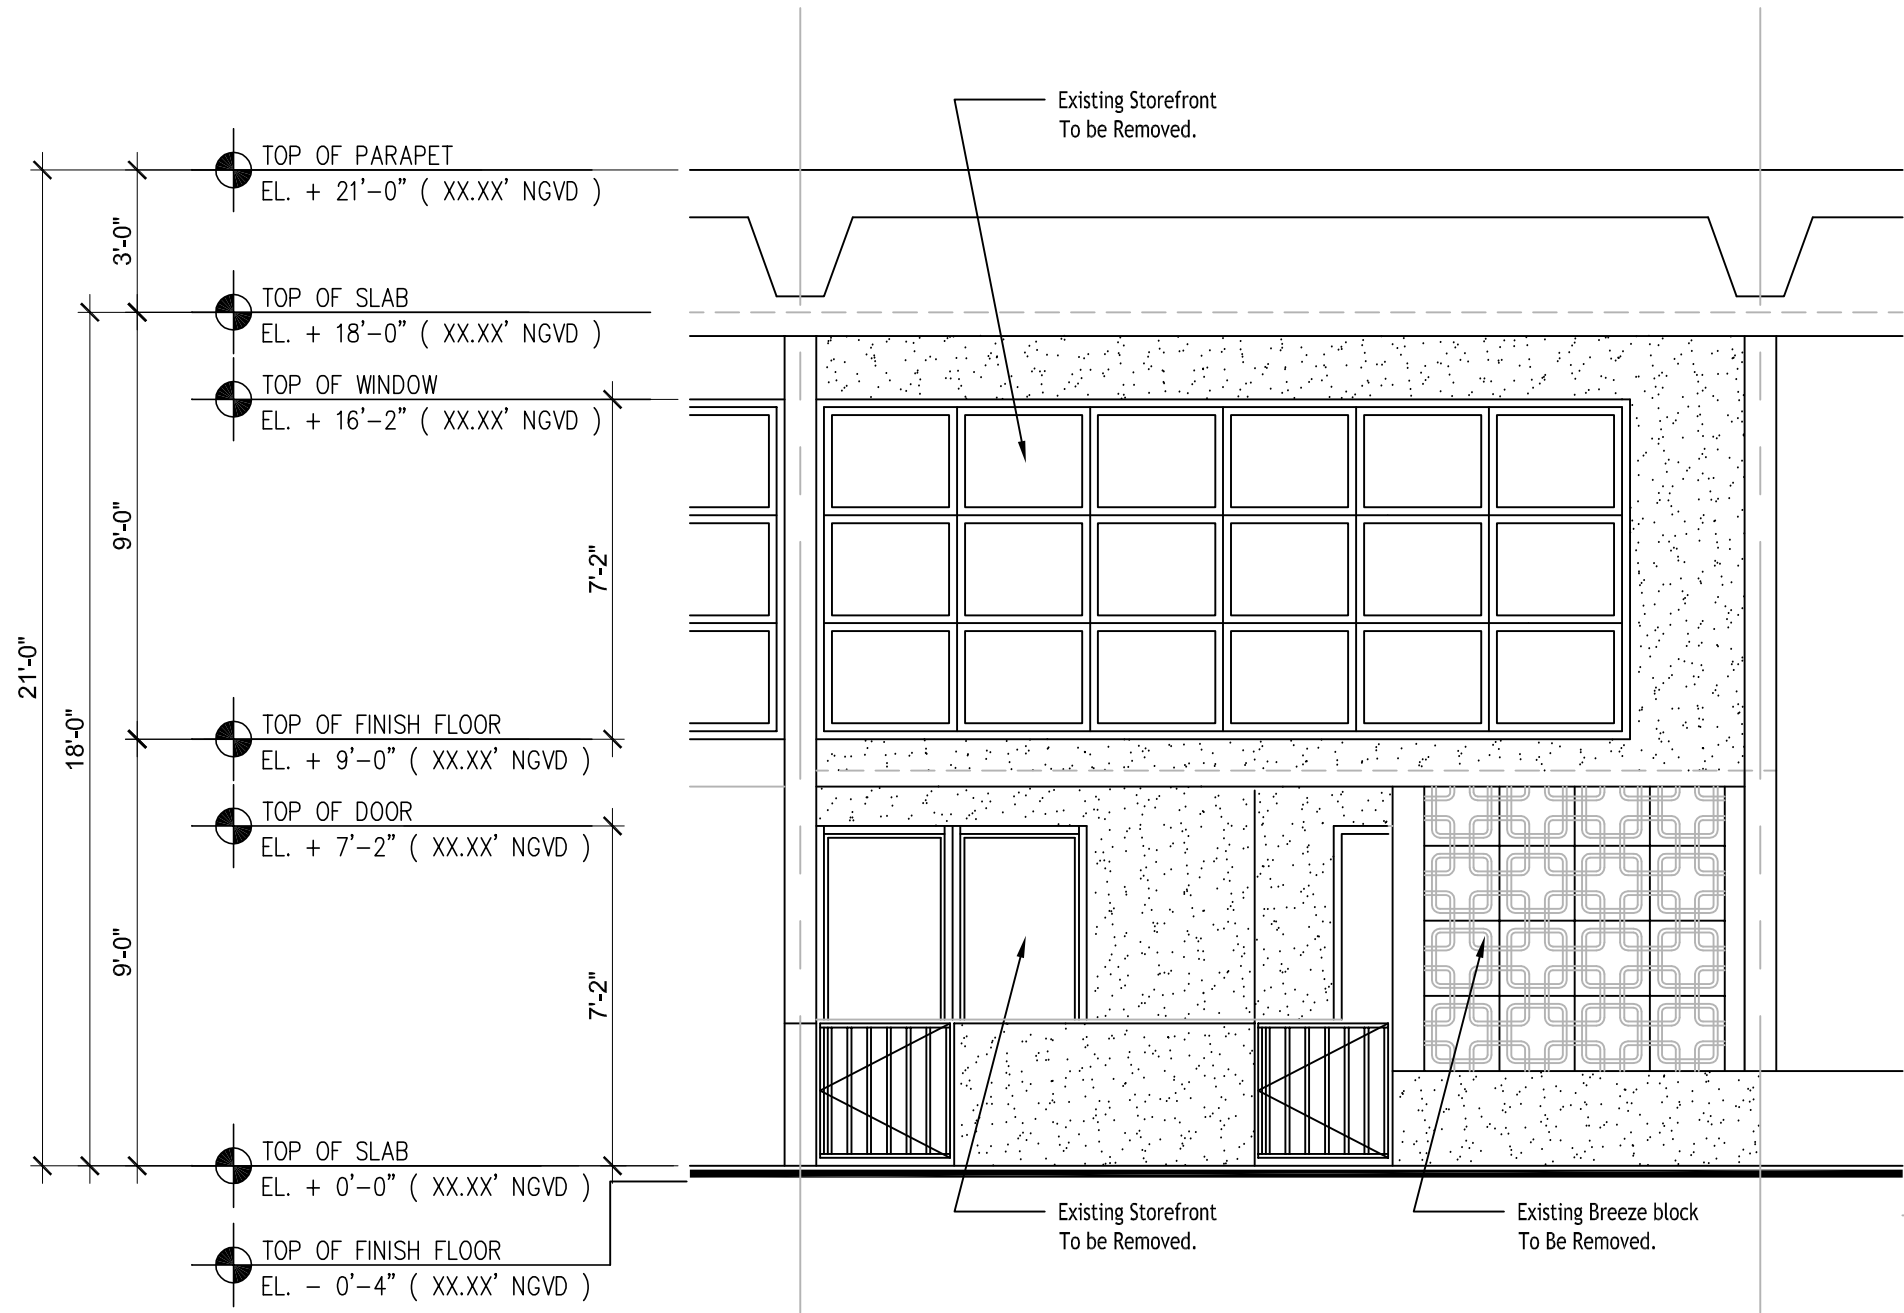

EXISTING: WEST ELEVATION
1/4"= 1'-0"

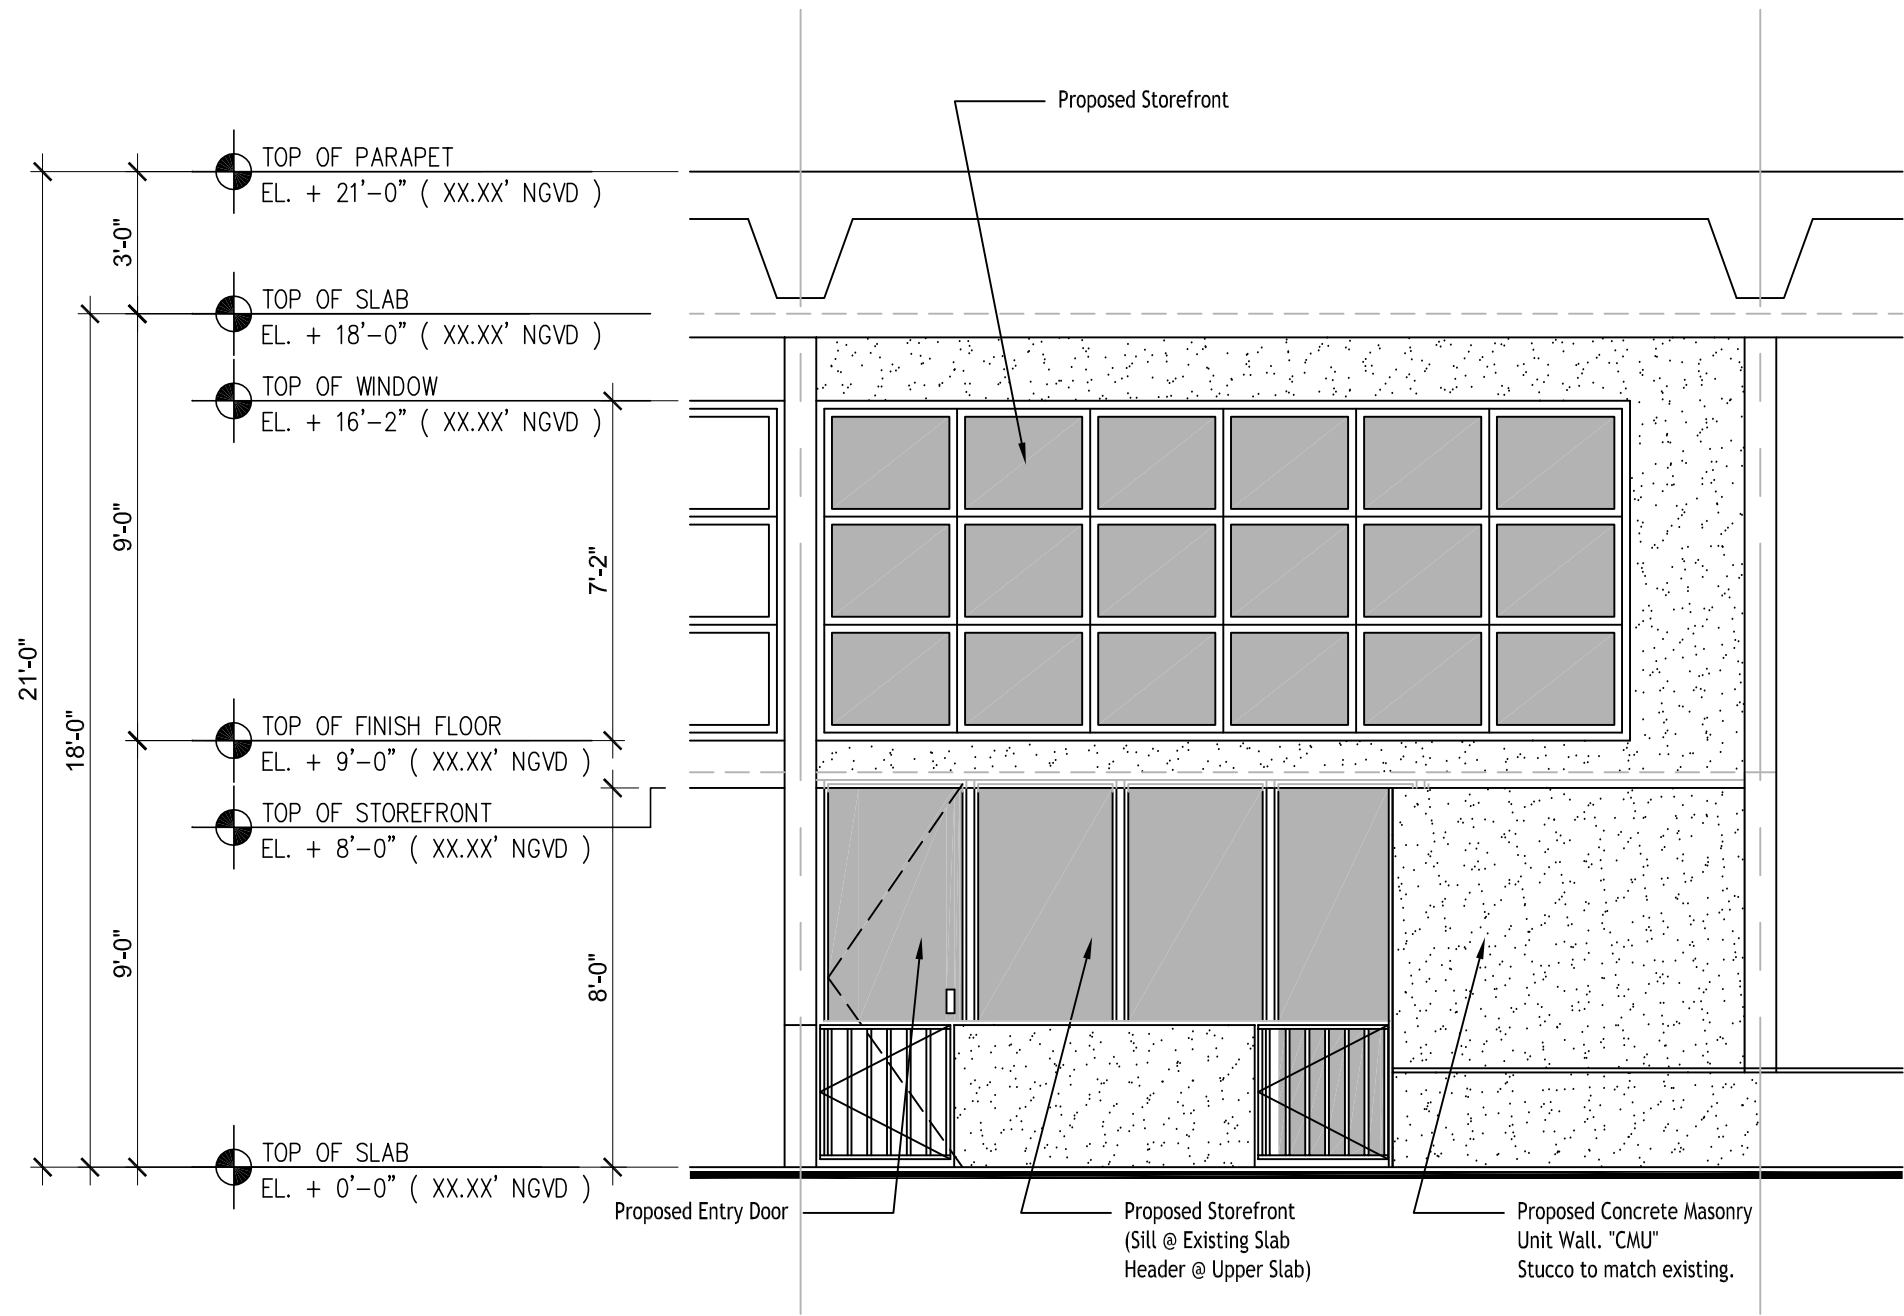

PROPOSED: WEST ELEVATION
1/4"= 1'-0"

DEMOLITION KEY NOTES:	
D1	G.C. REMOVE EXISTING DOORS AND SIDELIGHT. PREPARE FOR FINISH FLOOR AND PARTITION.
D2	GC TO RELOCATE EXISTING WASHER / DRYER. POINT OF SERVICE FOR WATER SUPPLY AND SANITARY TO BE EXTENDED. DRYER EXHAUST TO BE CONNECTED EXISTING SLAB OPENING.
D3	GC TO REMOVE AND REPLACE EXISTING BASEBOARDS. PATCH AND PAINT AS REQUIRED.
D4	GC TO REMOVE EXISTING WALL AND PARTITION TO CEILING. PATCH AND PAINT AS REQUIRED.
D5	EXISTING PLUMBING FIXTURES, SUPPLY LINES, SANITARY LINES AND ALL VENT STACKS TO BE RECONNECTED PER PROPOSED SCOPE OF WORK. CAP FLOOR AS REQUIRED.
D6	NOT USED
D7	G.C. REMOVE EXISTING TILE FINISH AND PREPARE SUB-BASE FOR NEW TILE INSTALLATION.
D8	GC TO PROTECT EXISTING INTERIOR DOORS, HARDWARE, ACCESSORIES AND ADJACENT COMPONENTS AND PREPARE FOR PROPOSED DOORS. REMOVE AND REPLACE CASING.
D9	EXISTING LIGHTING POWER TO REMAIN AND TO BE USED FOR PROPOSED LIGHTING LAYOUT.
D10	REMOVE EXISTING RAILING
D11	REMOVE EXISTING BREEZE BLOOK

CONSTRUCTION KEY NOTES:	
C1	EXISTING LAUNDRY TO BE REMOVED AND RELOCATED TO THE UPPER LEVE. EXISTING EXHAUST DUCT TO REMAIN AND RECONNECTED TO PROPOSED DRYER LOCATION.
C2	PROPOSED AC RELOCATED : SUPPLY, RETURN, AND REFRIGERANT LINES COORDINATED AFTER DEMOLITION PHASE
C3	EXISTING CONCRETE BEAM : FINISH TO BE REMOVED AND CONFIRM AS-BUILT CONDITION
C4	PROPOSED DRYWALL TO BE FRAMED TO MATCH EXISTING ADJACENT PARTITION. SPACKLE AND PAINT AS REQUIRED.
C5	PROPOSED IMPACT RATED STOREFRONT AND SLIDING GLASS DOORS UNDER SEPARATE PERMIT.
C6	PROPOSED FINISH FLOOR TO BE SLECTED BY OWNER
C7	EXISTING RAILINGS TO REMAIN
C8	PROPOSED CONCRETE BLOCK WALL TO REPLACE THE EXISTING BREEZE BLOCK WALL. STUCCO FINISH AND PAINT TO MATCH EXISTING.
C9	PROPOSED DRYWALL DROP CEILING AS NEEDED FOR PROPOSED LIGHT FIXTURES.
C10	EXISTING ROOF OVERHANG
C11	NOT USED
C12	NOT USED

DATE	REVISION
23.09.07	SITE AS-BUILT
23.09.07	AS-BUILT PLANS
23.09.11	RETAINED
23.10.24	SD
23.11.28	SD
23.12.02	SD
23.12.07	SD
23.12.11	SD

DATE:	23.10.15
DRAWN BY:	hobo:JS
PROJECT No:	1865BR

SHEET No: